
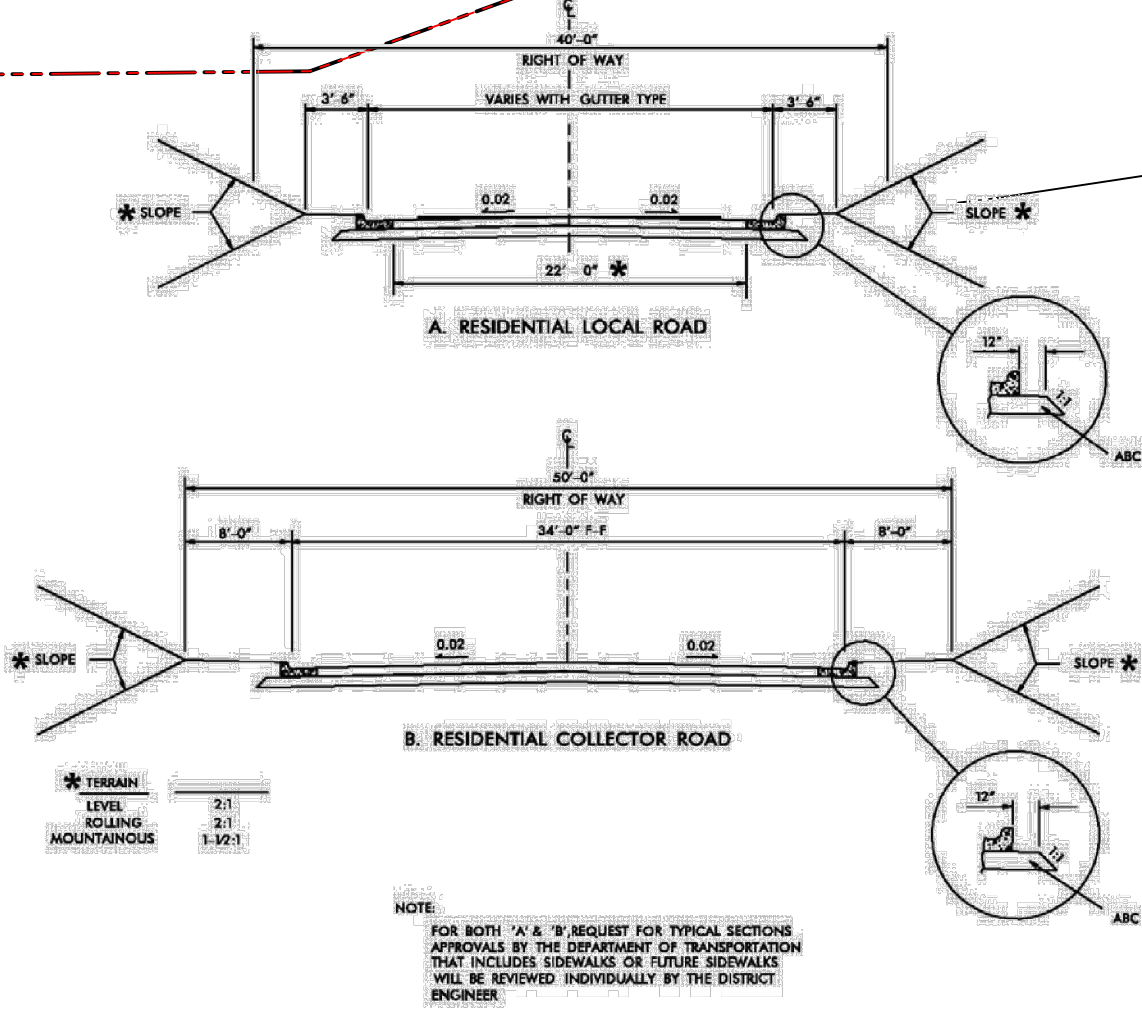
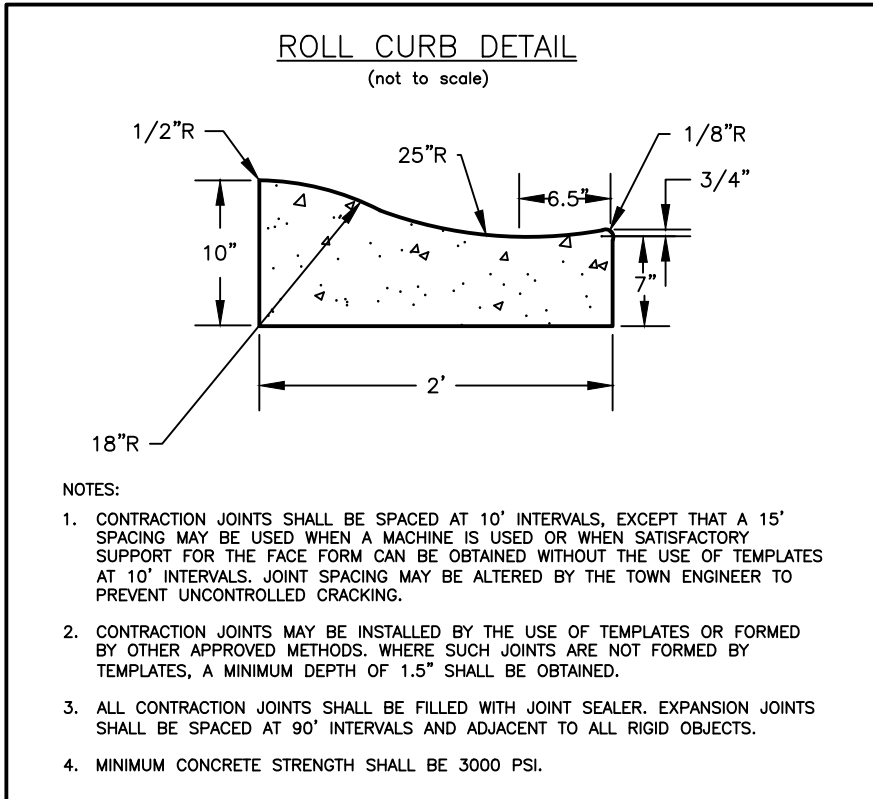


LEGEND

ROW	RIGHT-OF-WAY
SCM	STORMWATER CONTROL MEASURE
SS	SANITARY SEWER

<u>SITE SUMMARY DATA</u>	
PROJECT:	HERNDON FARMS
PROJECT ADDRESS:	US 15-501 N CHAPEL HILL, NC 27517 18909, 18896, 18897, 2752
AKPAR:	68.36 ACRES
TOTAL SITE ACREAGE: (DEEDED)	6,297 LF
PUBLIC STREETS:	1,435 LF
PRIVATE STREETS:	R-1
CURRENT ZONING:	WS-IV; NSW (PROTECTED)
WATERSHED:	
SETBACKS:	
FRONT	10 FEET
AGGREGATE FRONT/REAR	20 FEET
AGGREGATE SIDE YARD	10 FEET
CORNER SIDE	10 FEET
DEVELOPER:	SAPROLITE DEVELOPMENT, LLC 1506 EAST FRANKLIN STREET, SUITE 300 CHAPEL HILL, NC 27514
CONTACT:	TRAVIS BLAKE
PHONE:	(919) 260-4881
EMAIL:mtblake@outlook.com	
CONSULTANT:	ARCADIA CONSULTING ENGINEERS, PLLC P.O. BOX 2077 APEX, NC 27502
CONTACT:	TRENTON D. STEWART, PE
PHONE:	(919) 363-1422
FAX:	(919)363-1477
EMAIL:trrent@arcadiaengineers.com	

CHATHAM COUNTY REVIEW COMMENTS

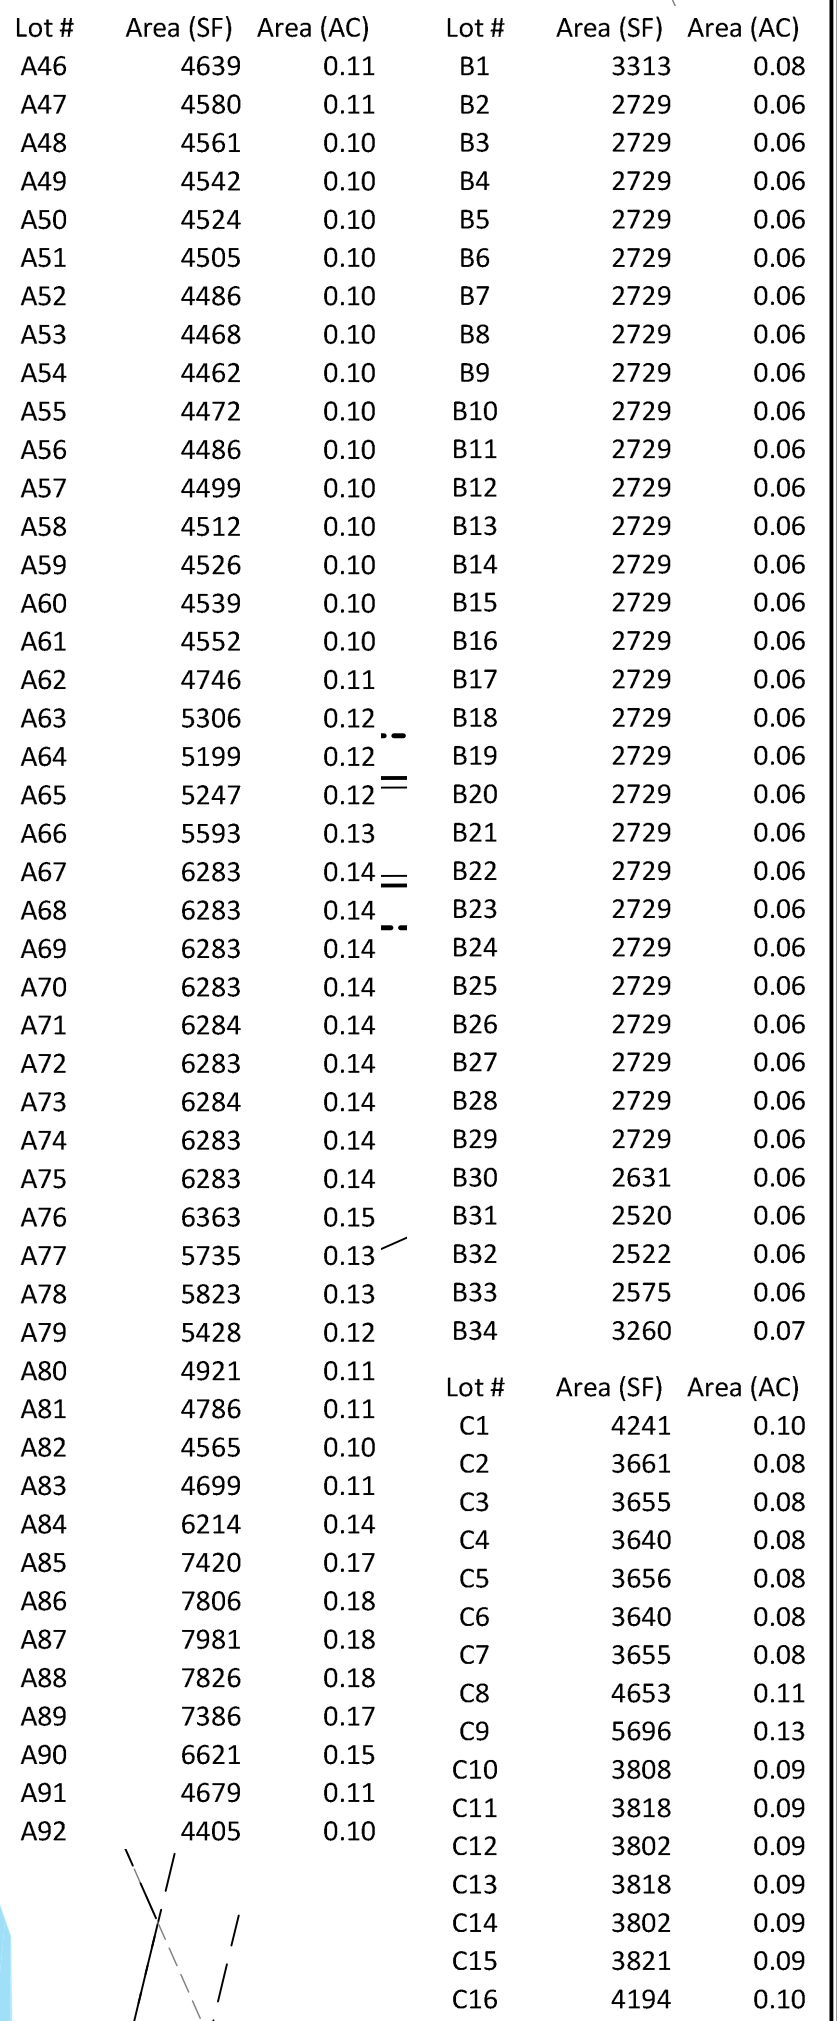

WILLIAMS TOWNSHIP CHATHAM COUNTY NORTH CAROLINA

DRAWN BY	CHECKED BY
KAH	TDS
DATE	6/16/2021

[illegible]

NORTH TRACT -
FIRST PLAT

OF