

9 Acre Solar Array



Road along property Line

Barn

Barr

Side D

Rental



612 Side C

Side B

Side E

Vet

Side F

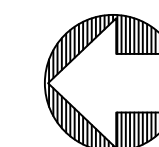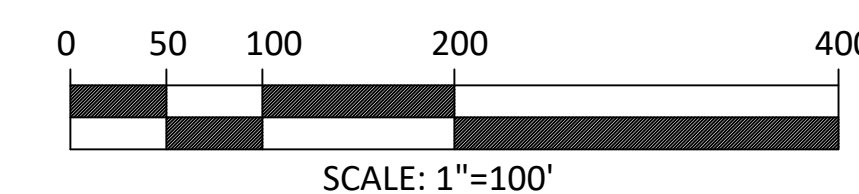

1 CHATHAM COUNTY REVIEW COMMENTS



PO BOX 2077
APEX, NC 27502
TELEPHONE: 919 363-1422
FACSIMILE: 919 363-1477



HERNDON FARMS

NORTH CAROLINA

CHATHAM COUNTY

WILLIAMS TOWNSHIP

DRAWN BY	CHECKED BY
KAH	TDS
DATE	6/16/2021

REVISIONS

[illegible]

SHEET TITLE

OVERALL SITE -
PRELIMINARY
GRADING AND
STORMWATER PLAN

SHEET NUMBER

SW1

1 OF 3